


© COPYRIGHT, THIS DOCUMENT AND DESIGN IS THE PROPERTY OF M&P GROUP. ANY REPRODUCTION OR USE OF THIS DOCUMENT WITHOUT THE WRITTEN PERMISSION OF M&P GROUP IS STRICTLY PROHIBITED. ALL WORK SHALL BE COVERED BY AN AGREEMENT WITH THE CORRESPONDING CODES AND STANDARDS. REFER TO THE SPECIFICATIONS TO THE ENGINEERING PROCEEDINGS WITH THE WORK.

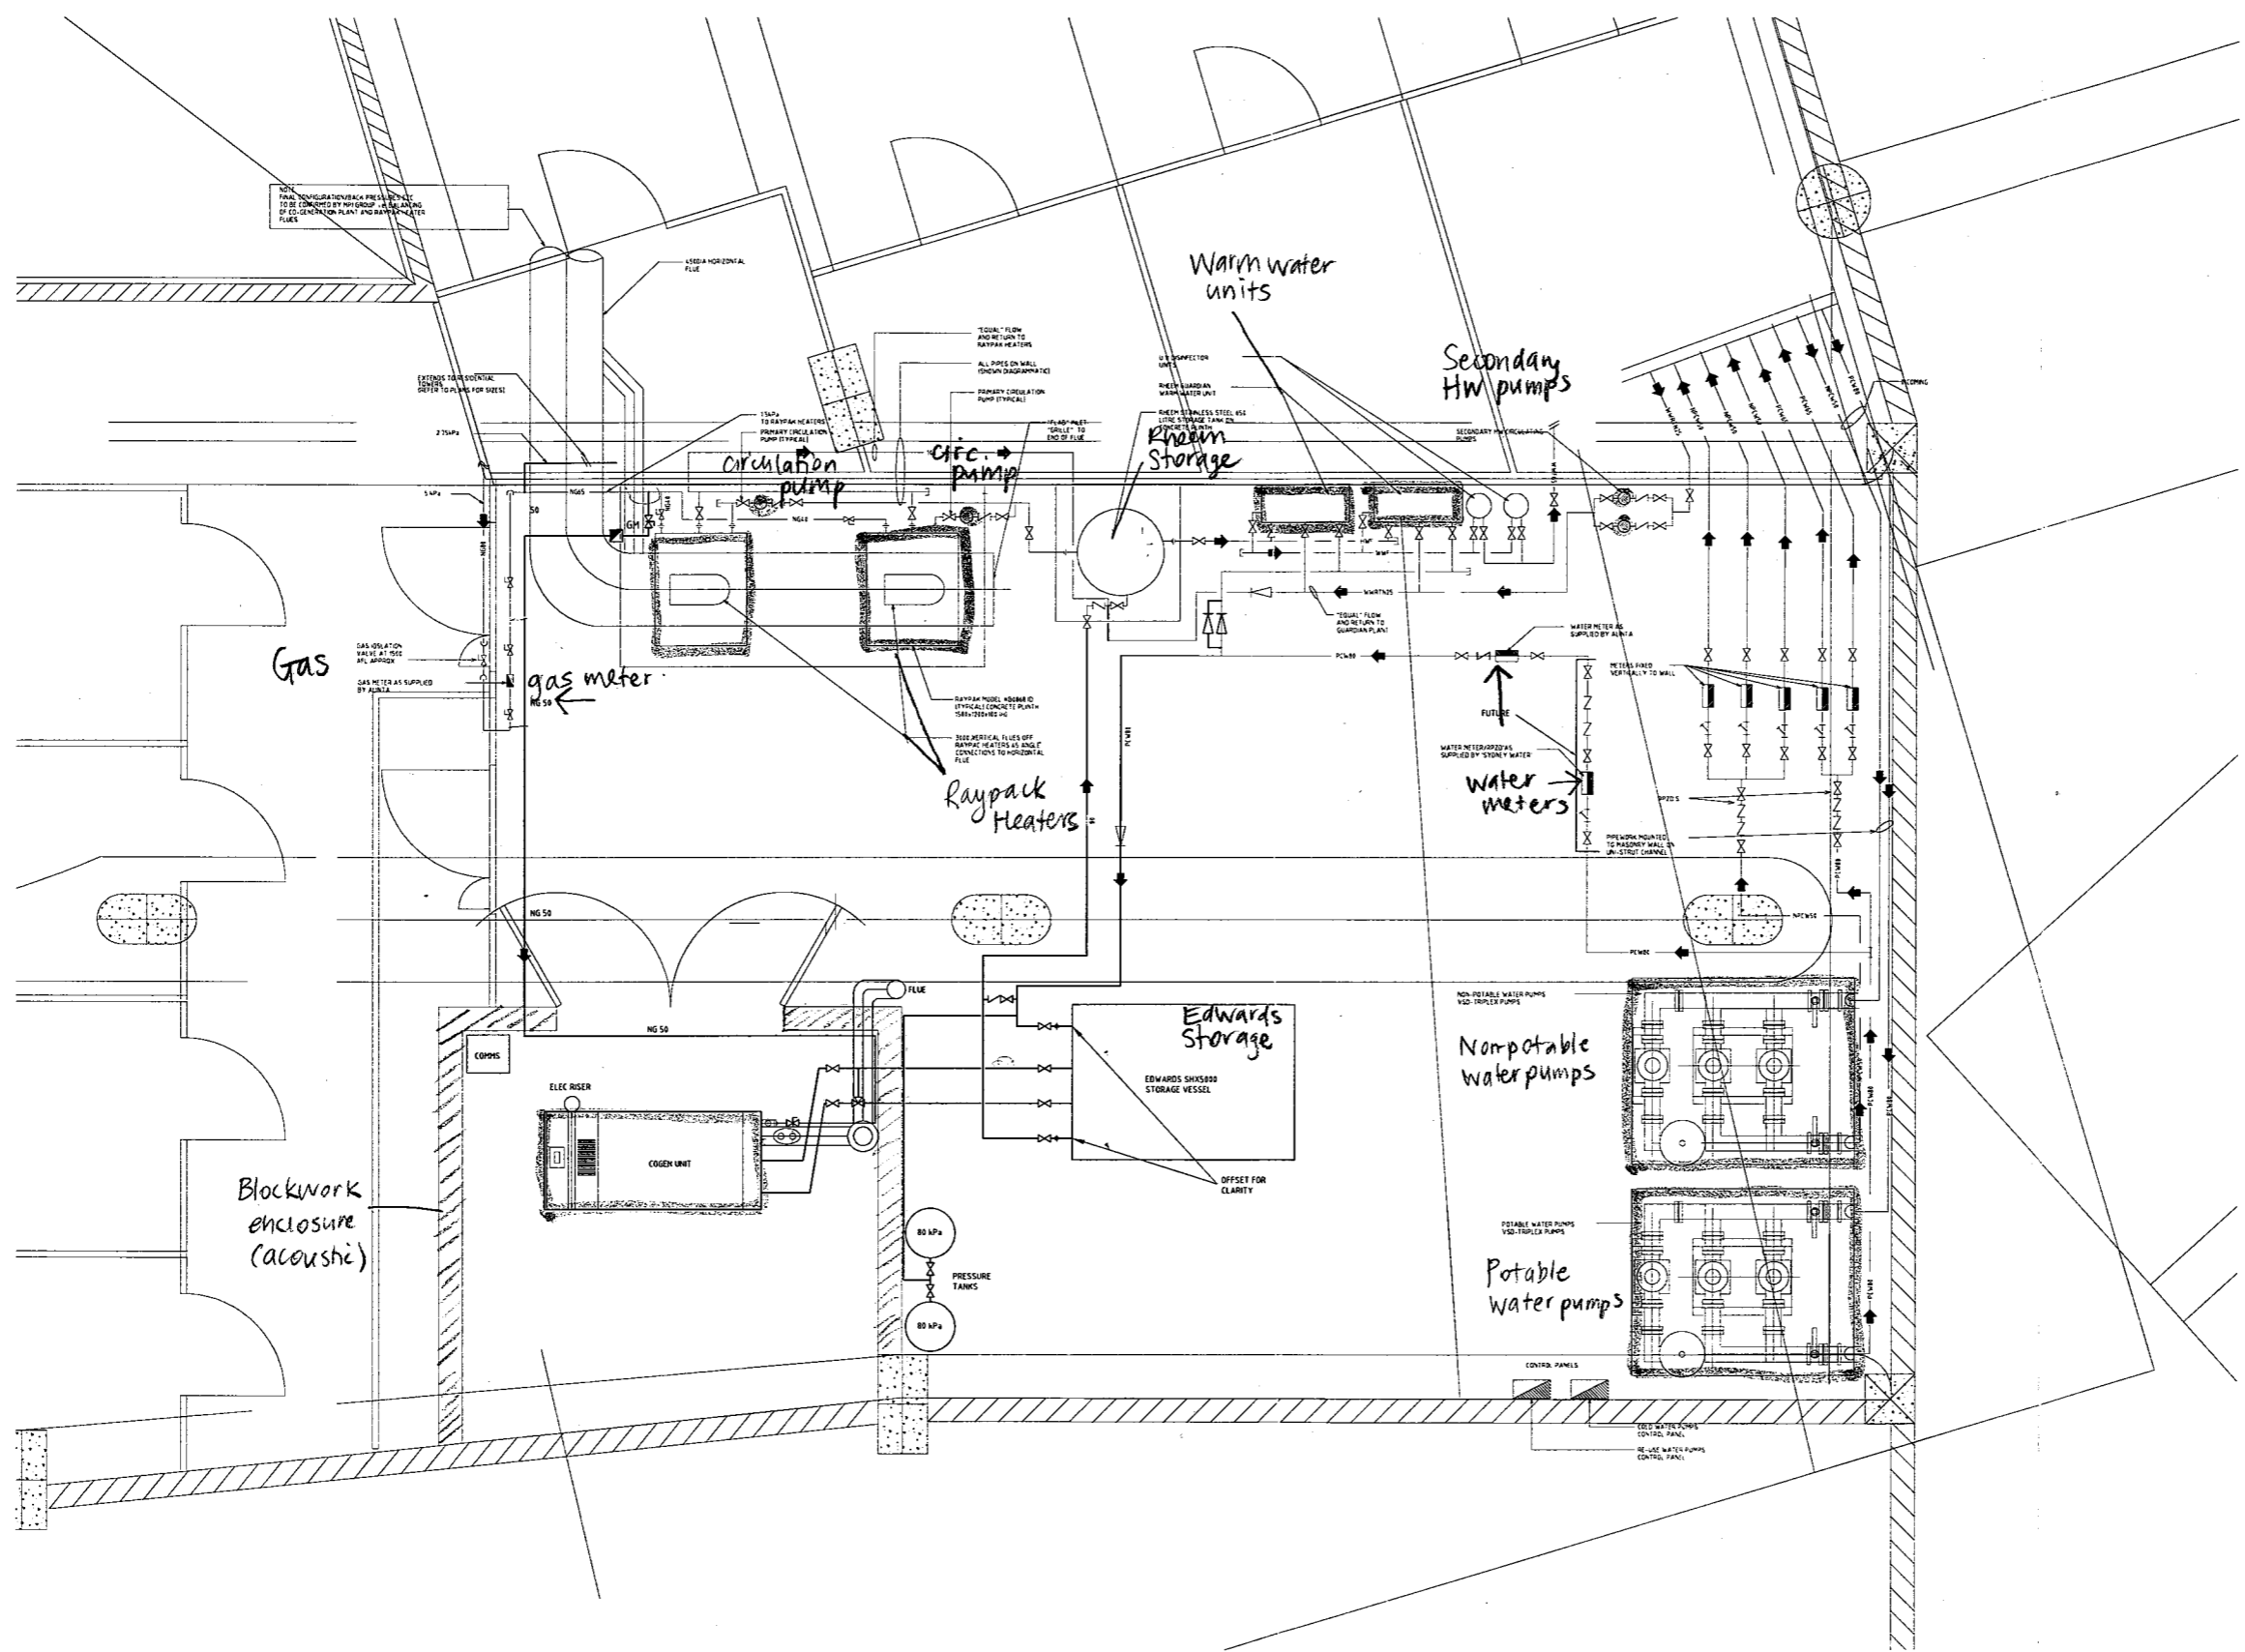

AS BUILT

NO.	DESCRIPTION	DATE	BY

Department of Planning  
Sustainability Unit

**MPI**  
M&P Group Australia Pty Ltd  
12/11-12/13 GARDNER ST  
SUNSHINE VIC 3020 Australia  
T: +61 (0) 8 8488 0000  
F: +61 (0) 8 8488 0099  
W: www.mpi.com.au

**ROUSE HILL TOWN CENTRE  
QUADRANT A & B RESIDENTIAL  
COGENERATION PROJECT**

**COGENERATION  
PLANT**

SCALE	1:20	PROJ. NO.	A0
DATE	26.03.08	DRWING NO.	P02
DATE	26.03.08	REVISION	0
DATE	26.03.08	APPROVED	TJR
DATE	26.03.08	DESIGNED	TJR
DATE	26.03.08	CHECKED	TJR
DATE	26.03.08	ISSUED	TJR